

INTERIOR SELECTIONS

CARPET

- BIGELOW
- REGENTS ROW NUMBER 3143: ALL AREAS SAME SELECTION;
- COLOR 09608 TARTANISE SHELL HEATHER, INCLUDING BASE.

CERAMIC TILE

- AMERICAN OCEAN
- FLOOR - 2' x 2' RIFWOOD
- BASE AND WAINSCOTS - 4' x 4' : GOLD MIST # 40.
- SKILL - 4' x 4' : YELLOW # 50.

CHALK & TACK BDS

- GREENSTEEL
- CHALKBOARDS - BROWN # G-95.
- TACKBOARDS - DARK BROWN # 2171.

COAT RACKS

- WAGEL PETERSON
- UNIT - ARCHITECTURAL BRONZE
- HOOKS - BLACK

DISPLAY CASE

- POBLOCK & SONS
- METAL - ANODIZED BRONZE
- TACKBOARD - DARK BROWN VINYL

FOLDING DOOR

- PELLA
- WALNUT VENEER - FACTORY FINISH

FOLDING PARTITION

- MODERNFOLD
- GLASS-MESH - GOLDEN GLOW # 344, ALL SAME SELECTION.

HEATING UNITS

- TRANE
- UNIT VENTILATORS - PLATINUM GRAY (647709/165).
- FAN COIL UNITS - SAME

METAL SHELVING

- REPUBLIC STEEL
- NEUTRAL L-14

PAINT

- GLIDDEN
- SELECTIONS ARE FOR COLOR ONLY. TYPE OF PAINT FOR VARIOUS AREAS AND SURFACES SHALL BE AS CALLED FOR IN SPECIFICATIONS.
- GRILLES, PANEL BOXES ETC. SHALL BE PAINTED TO MATCH ADJACENT SURFACE.
- WALLS - AC-933 - BASIC OFF WHITE.
- DOOR - PUCKS - AC-577 - DARK BROWN
- PEG BOARD IN ARTS & CRAFTS - AC-577

RESILIENT FLOORING

- ARMSTRONG
- ALL ONE SELECTION - COTTAGE TAN # 51930.
- TILE SHALL BE LAID WITH GRAIN IN ONE DIRECTION. DO NOT ALTERNATE.

RUBBER BASE

- FLEX-GROVE
- DARK BROWN - NUMBER 2

SHADES

- WOVEN WOOD
- PLA-SWOOD STAINED TO MATCH DOORS.

STAIN

- GLIDDEN
- CORRIPOR DISPLAY PLYWOOD, MAIL SLOT UNIT, SNACK AREA WALL, TELEPHONE BOOTH - SHALL MATCH PRE-FINISHED WOOD DOORS.
- SHELVES IN OFFICES 37 & 38 SHALL MATCH WALNUT PLASTIC LAMINATE BELOW

TOILET COMPARTMENTS

- GLOBAL
- DOORS, POSTS AND PARTITIONS - BRONZE # 1031.

VINYL WALL COVERING

- WICITEX - LIECAPELIER
- ONE SELECTION FOR COLUMNS AND CORE SIDE OF CORRIDOR WALLS - PATTERN - CORRA, COLOR - PAPAYA # 426

WOOD DOORS

- EGGER'S PLYWOOD CO. (ONE FINISHED)
- GARDALL FRUITWOOD

EQUIPMENT FINISHES

EDUCATIONAL

- EDUCATOR'S INCAVITE LINE
- CONFERENCE 25 - FRONT TEAK, TOP - ANTIQUE WHITE.
- DEMO KITCHEN 24 - FRONT & ENDS - TEAK; TOP - ANTIQUE WHITE.
- OFFICES 37 & 38 - FRONT, ENDS & TOP - WALNUT.
- TEACHERS CABINETS - ALL PARTS - TEAK.

KITCHEN UNITS

- GENERAL ELECTRIC
- RANGE, REFRIGERATOR & DISHWASHER - HARVEST GOLD

SHELVING

- BROADHEAD GARNETT CO.
- ARTS & CRAFTS RM. 45 - GRAY

EXTERIOR SELECTIONS

ALUMINUM

ENTRANCES

- KAWNEER
- CLASH FINISH ALUMINITE

GLAZES, GEANEL

- REYNOLDS, COLORWELD 200.
- MCCRA BRONZE
- HOPE WINDALUME SERIES 4000
- FINISH ZODRI - ANODIZED
- PANEL - TO MATCH CYBER BLDG'S OF THE COLLEGE.

WINDOWS

- BEILDIN BRICK CO.
- BORNBANK BLEND WITH FLUSHED BRICK ELIMINATED.
- GLIDDEN
- HOLLOW METAL DOORS & TRIM - AC-577
- OUT RIGGERS - MATCH ALUMINUM GRAVEL STOP - MCCA BRONZE

PAINT


- GLIDDEN
- OUT RIGGERS - MATCH ALUMINUM GRAVEL STOP - MCCA BRONZE

SIDING

- GLIDDEN
- COLOR - COP R - PAUL

STUCCO

- ORIENTAL EXTERIOR STUCCO
- WHITE

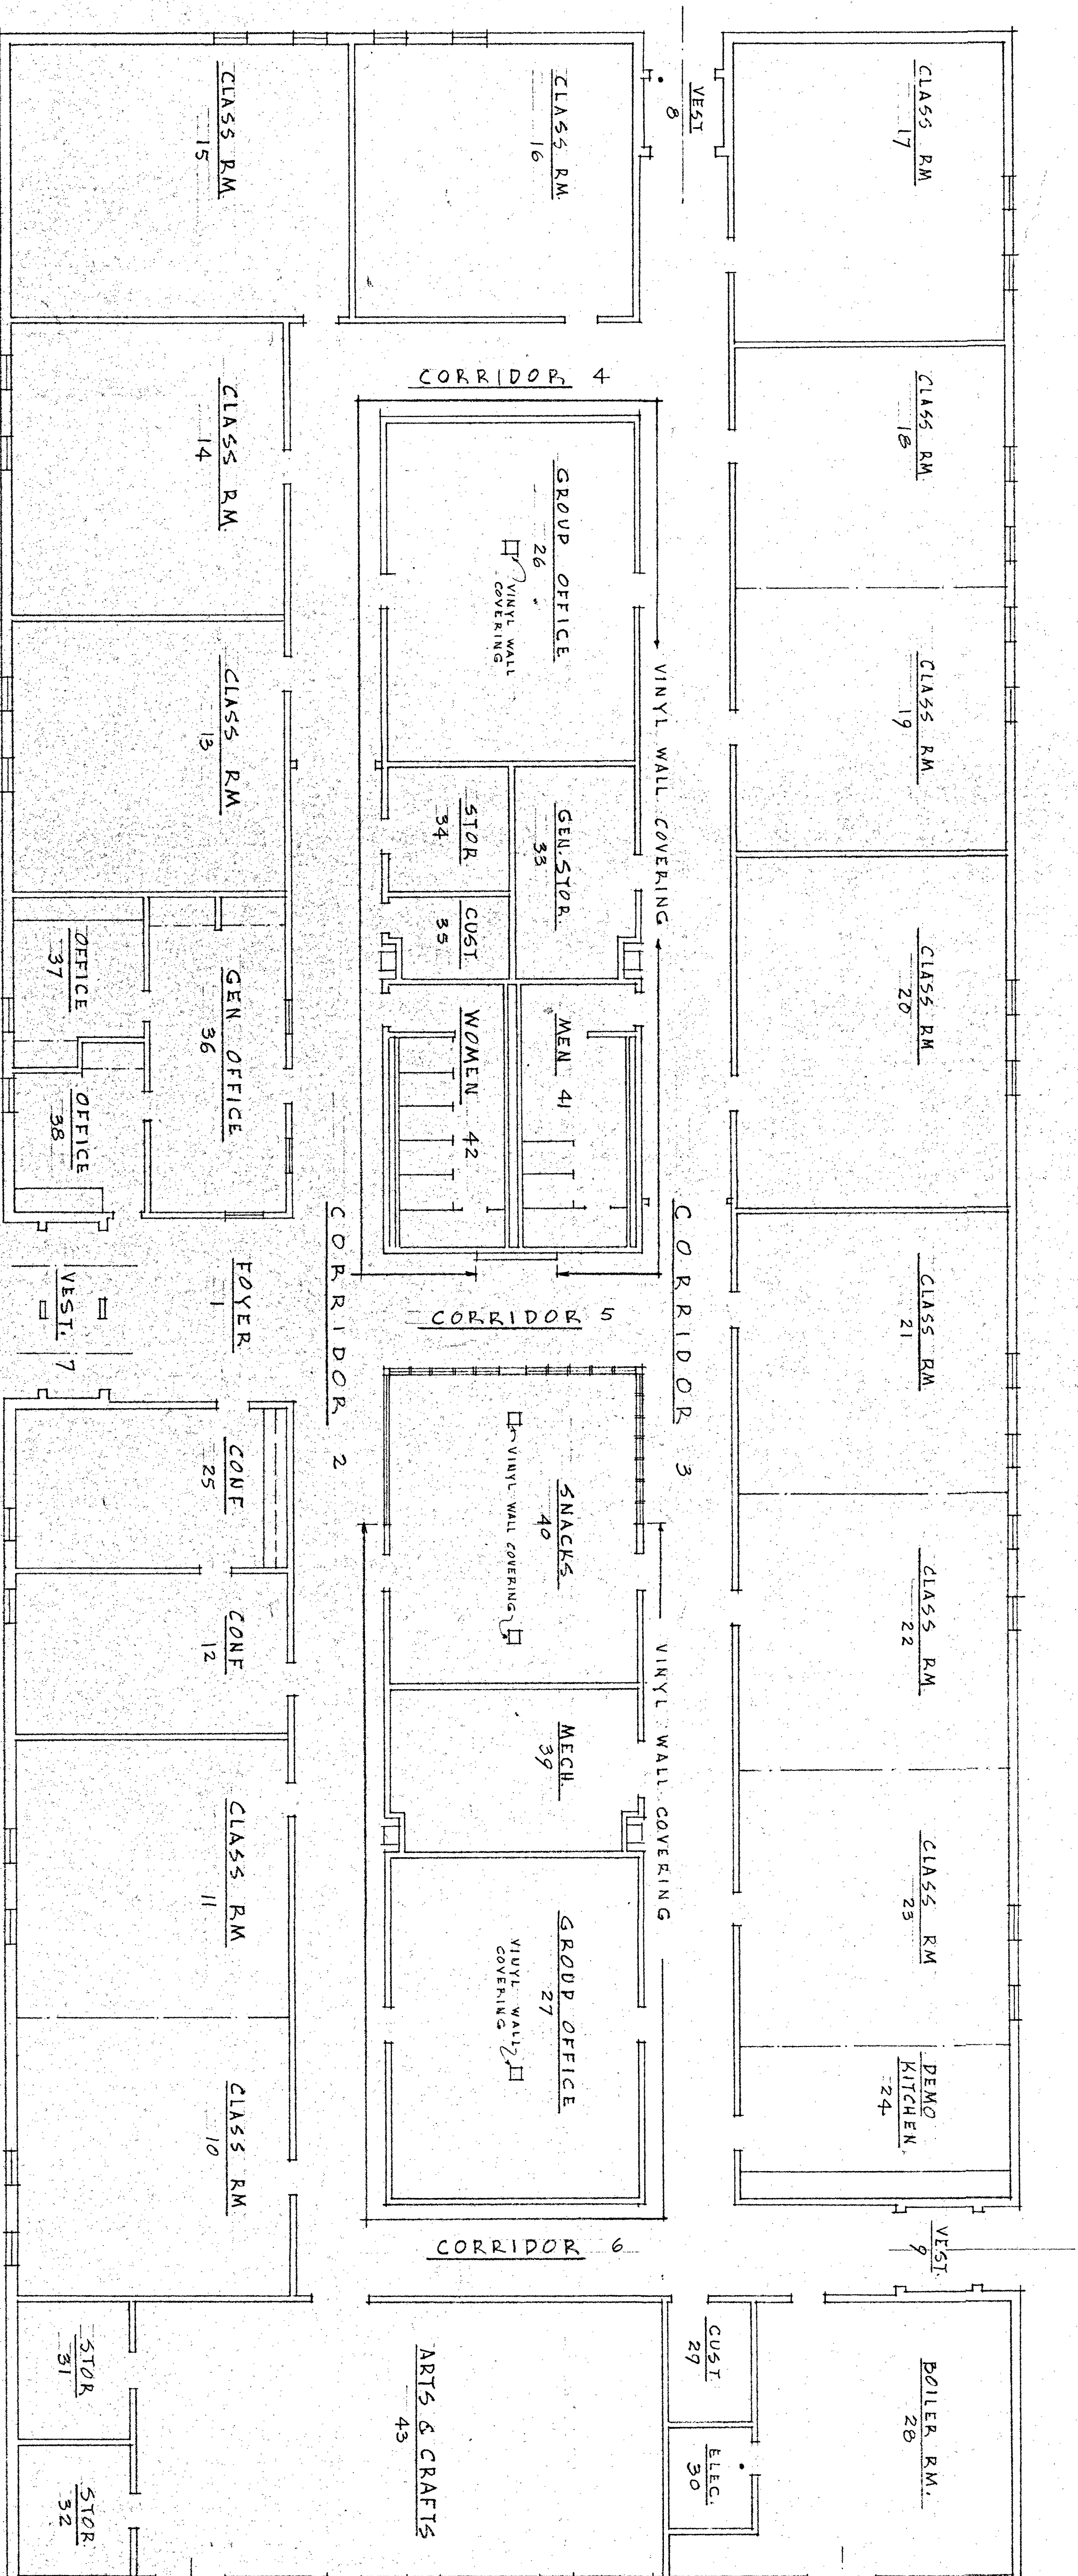

GENERAL NOTES

- COLORS AND PATTERNING AS NOTED HEREIN FOLLOW THE CODE NUMBERS AND KEY DESIGNATIONS OF THE RESPECTIVE MANUFACTURERS.
- WHEN PRODUCTS OF SPECIFIED MANUFACTURERS NOT NOTED IN THIS SCHEDULE ARE SUBMITTED, THE COLOR SHALL MATCH THE DESIGNATED COLOR EXACTLY OR THE TO ARCHITECT RESERVES THE RIGHT TO MAKE A SELECTION AT NO ADDITIONAL COST TO THE OWNER, REGARDLESS OF MANUFACTURER'S SPECIAL OR PREMIUM DESIGNATIONS.

COLOR SCHEDULE

DATE	BY	APPROVED	FOR	PROJECT	LOCATION
3-1-77	A-5	JOHANNES & MURRAY & ASSOCIATES	Continuing Education Building	ALLEGANY COMMUNITY COLLEGE	CUMBERLAND - MARYLAND