

ROOF FRAMING PLAN

- NOTES:
1. TOP OF STL. BEAMS SHOWN ON PLAN THIS: (COO.00)
 2. JOISTS MARKED SLOPE PLAN TO BE BOLTED TO BR OR COL.
 3. SEE STRUCT. NOTES (DWG 55) FOR METAL ROOF DECK.
 4. SEE DWG. 55 FOR TYPICAL ROOF DETAILS.

LINTEL SCHEDULE


MARK	SIZE	REMARKS
L1	10' x 8' BRIDGE CONC.	TR. OVER 30' HUNG
L2	2' x 4' TOP & BOT. 2' x 6' x 10' PRECAST CONC.	-
L3	W10x25 W/16 SUSP. PL.	I-434CL

BEARING PLATE SCH.


MARK	SIZE
B121	8' x 1/2' x 10' 8'
B122	6' x 1/2' x 10' 8'
B123	6' x 1/2' x 10' 8'

NOTES: PROVIDE 2' x 1/2' x 10' 8' B121, B122, B123.


FRAMING PLAN ~ SCREEN ABOVE ROOF

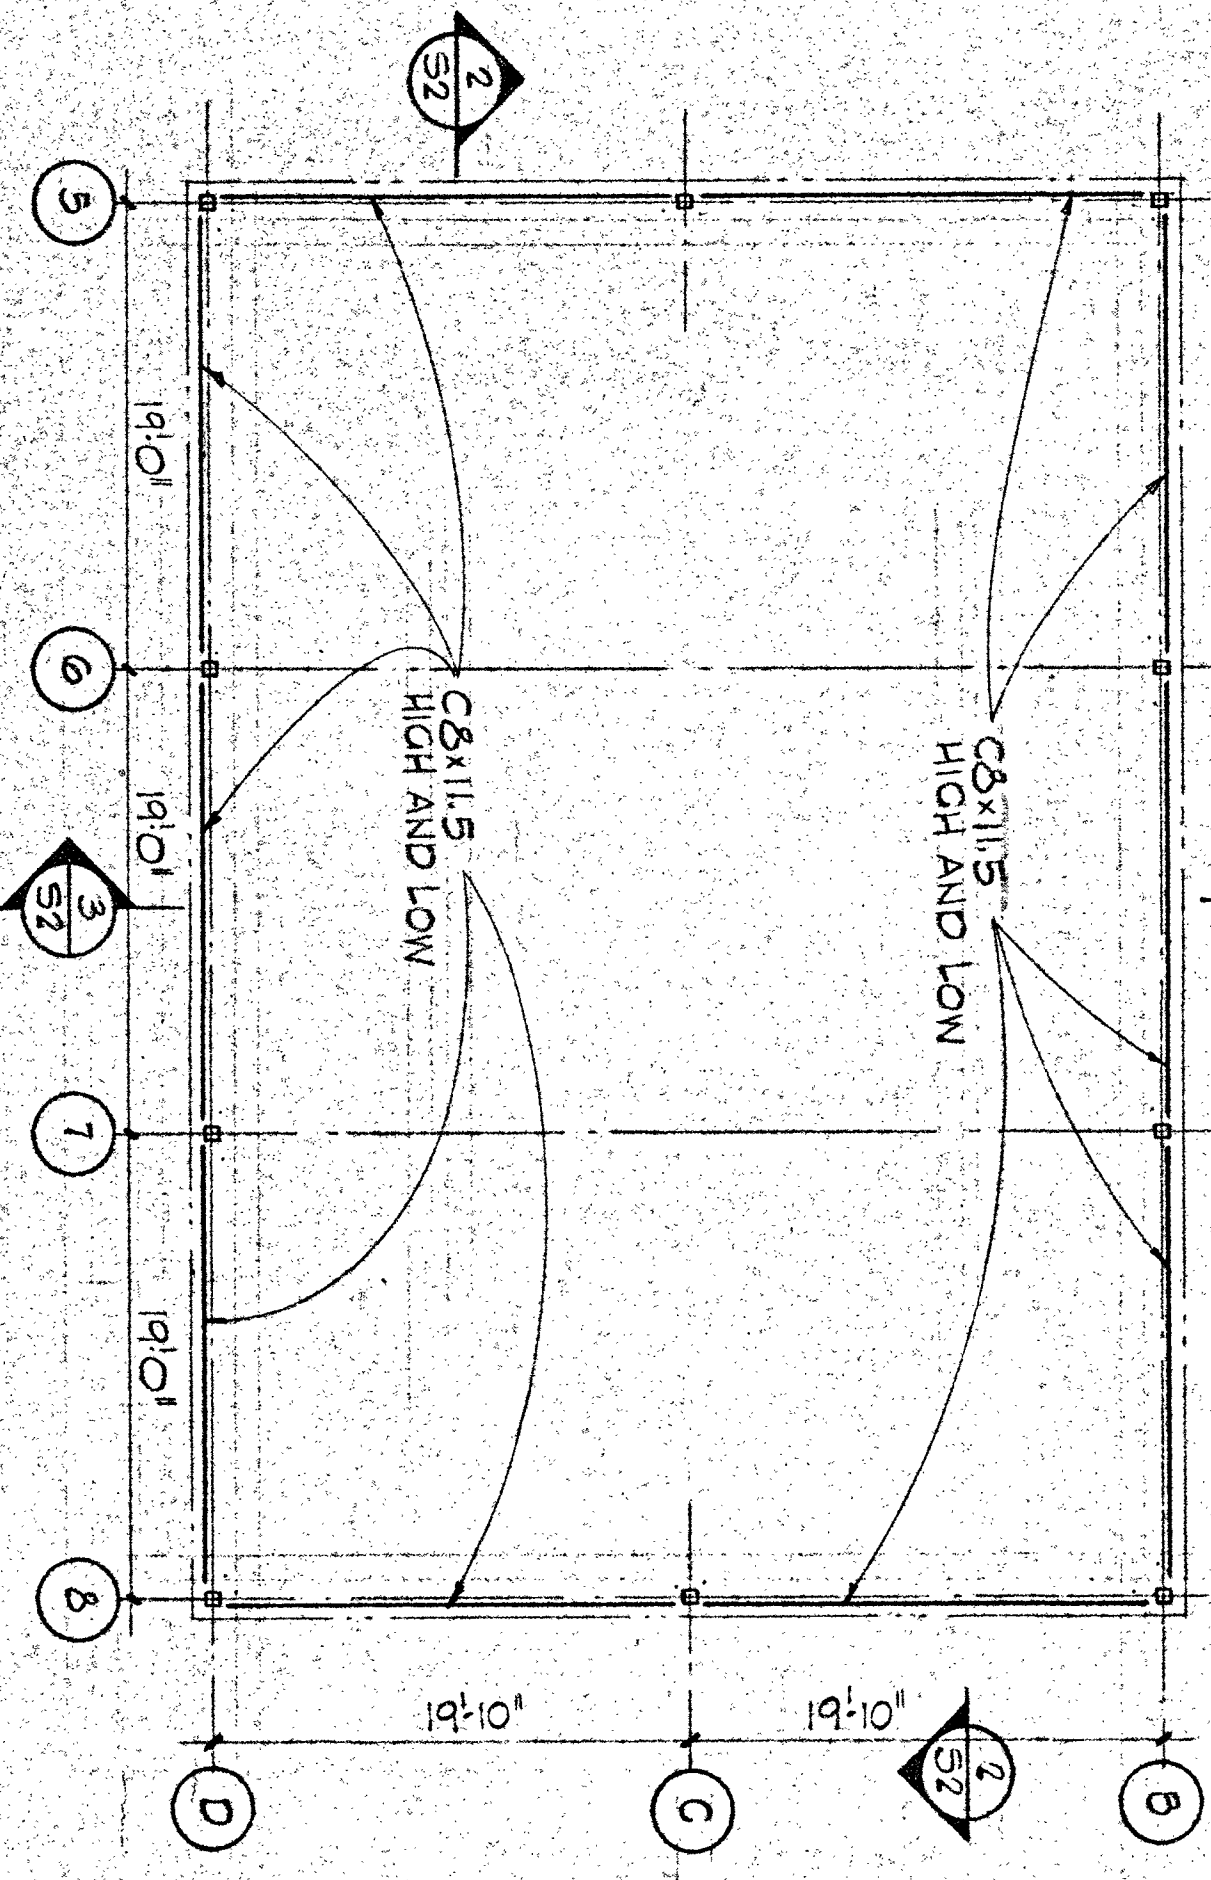




SECTION 4

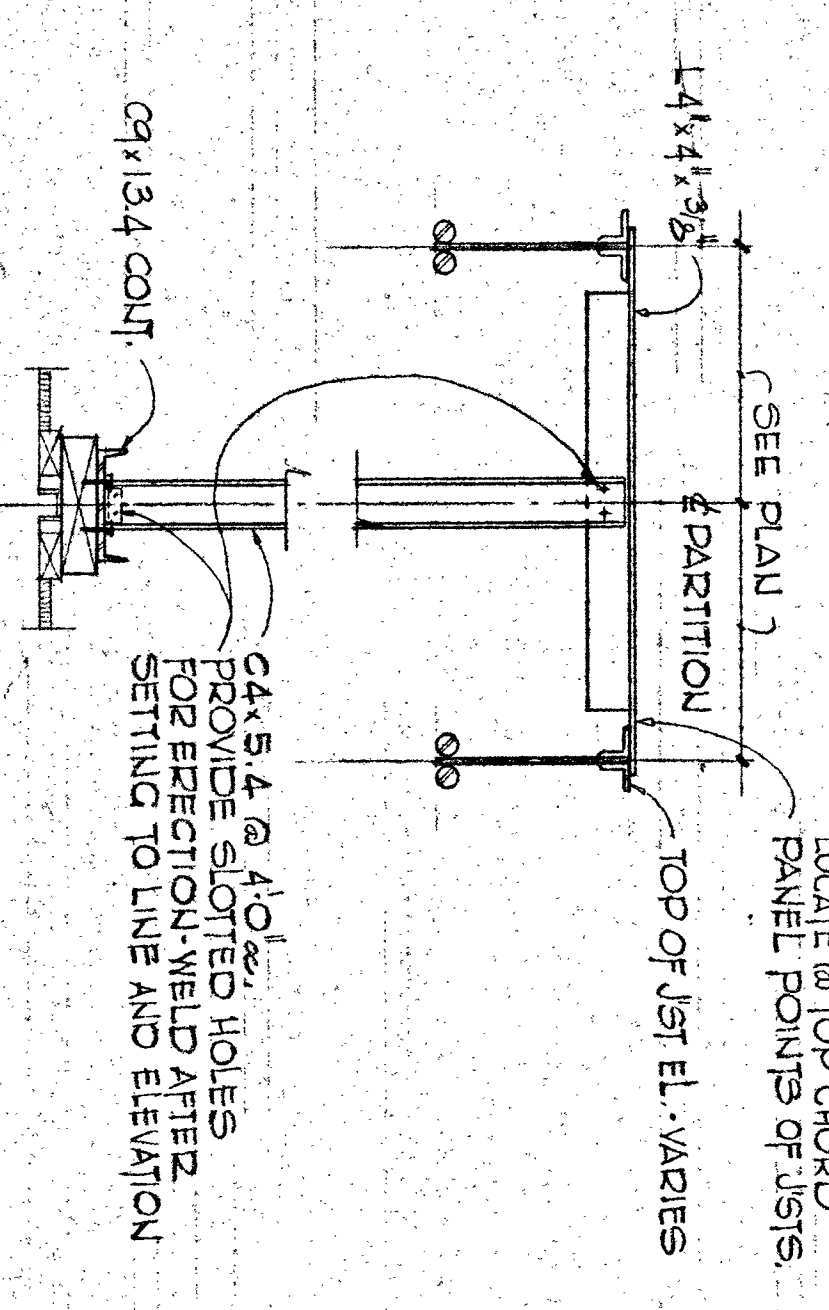

SECTION 2

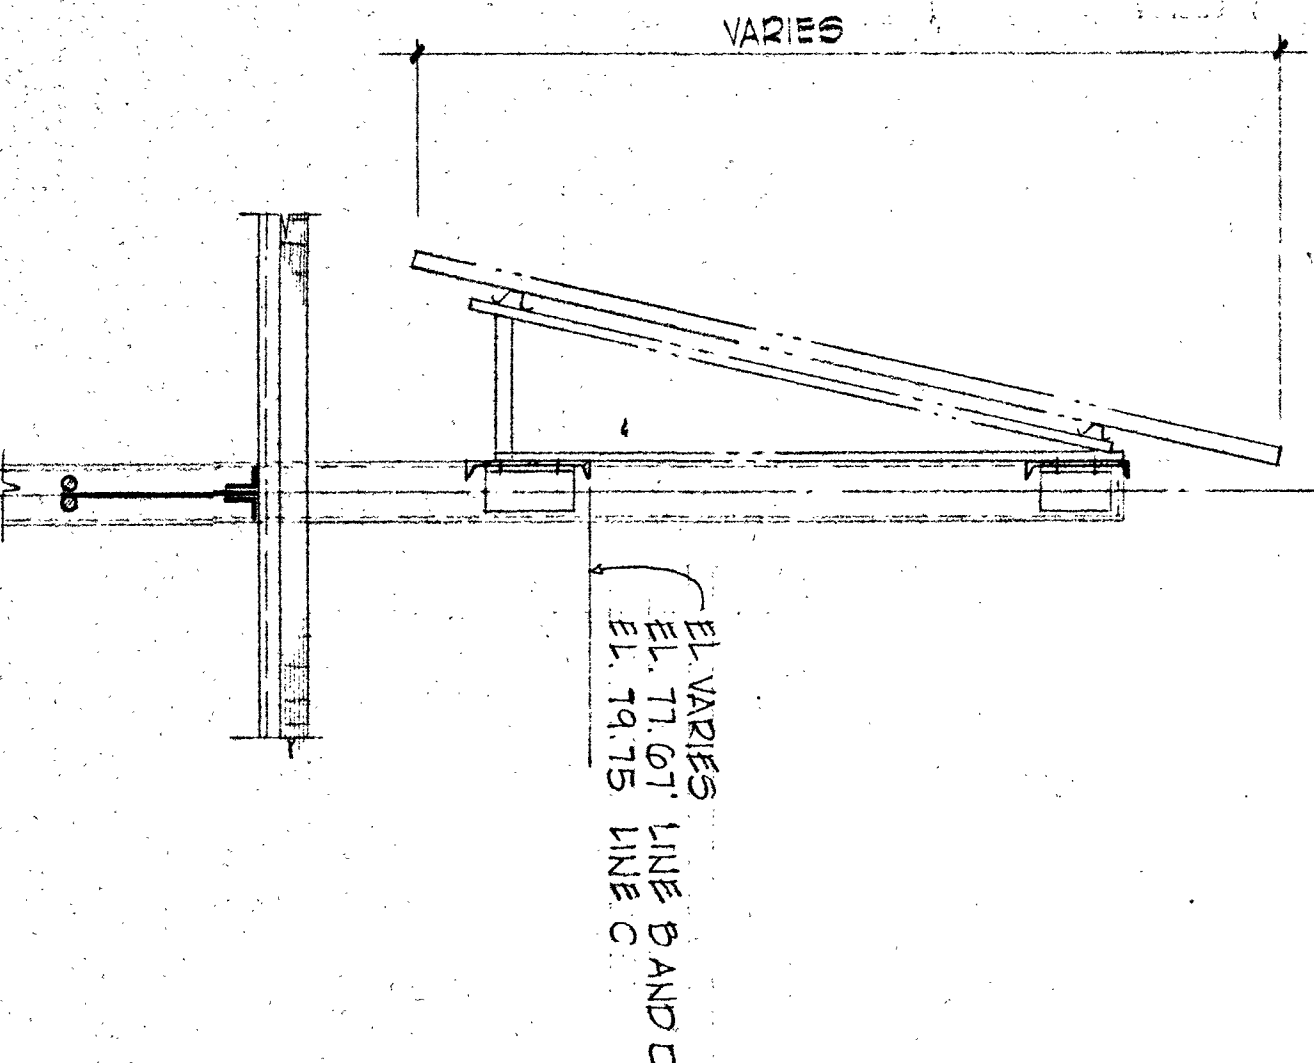

SECTION 1

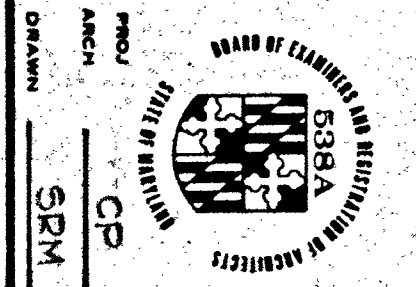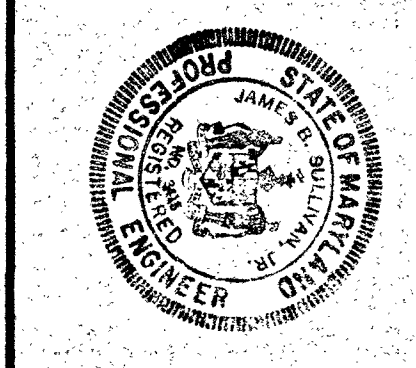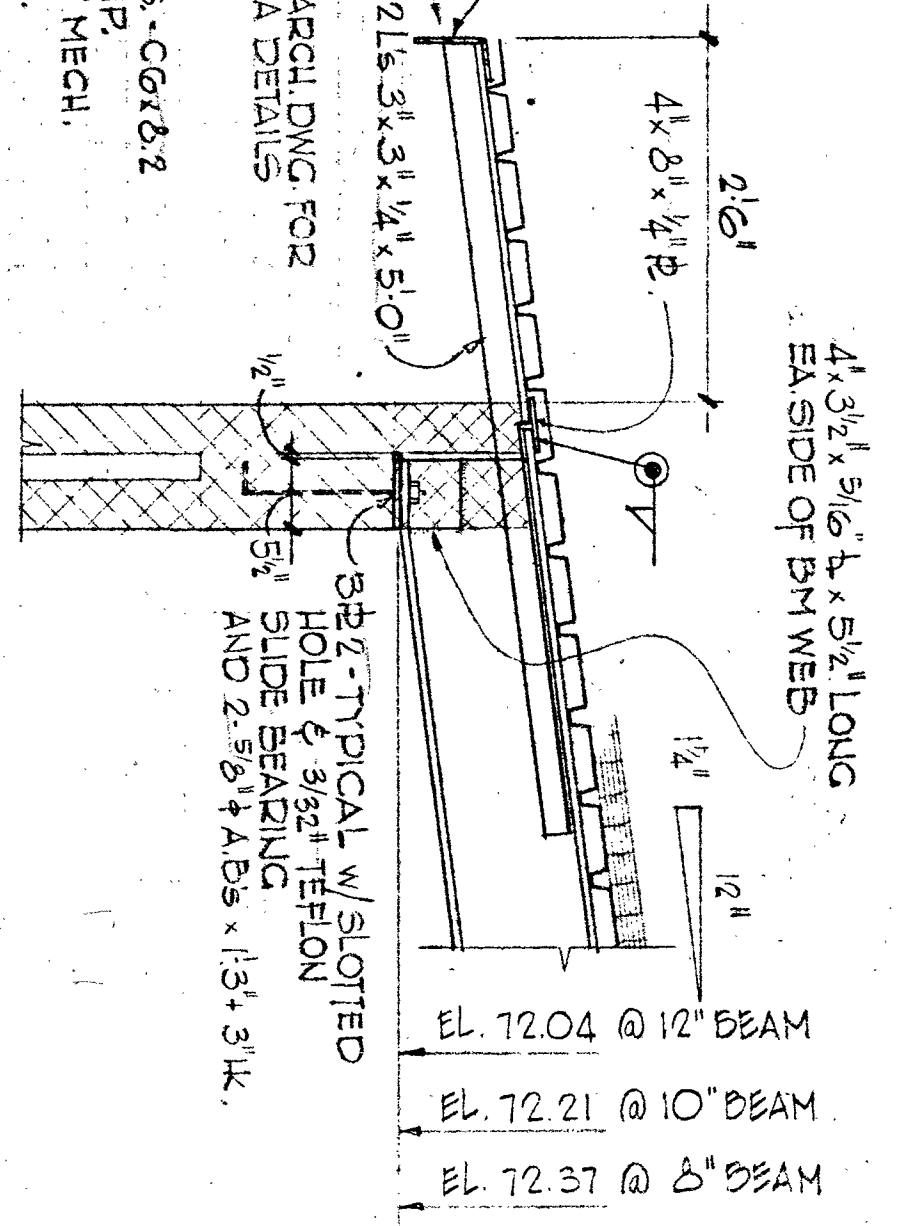

JOHANNES & MURRAY & ASSOCIATES, INC.
REGISTERED PROFESSIONAL ENGINEERS
2000 PERIMETER DRIVE, SUITE 200
COLUMBUS, OHIO 43260
614.261.1000
FAX: 614.261.1001
WWW.JMA-ENGINEERS.COM

APPROVED: *[Signature]*
DATE: 3/1/77

CLIENT: ALLEGANY COMMUNITY COLLEGE
CUMBERLAND - MARSHLAND

PROJECT: CONTINUING EDUCATION BUILDING

DATE: 5/4/06
PAGE: 3
REV: 3/1/77