


# SPECIAL NOTES

1. DO NOT SCALE DRAWINGS.
2. ELECTRICAL PLANS ARE DIAGNOSTIC ONLY, DIMENSIONS AND SIZES ARE MINIMUM.
3. CONSULT DRAWINGS OF ALL OTHER TRADES FOR RELATED AND ADJOINING WORK.
4. CONSULT ARCHITECTURAL & STRUCTURAL PLANS AND DETAILS FOR EXISTING AND PROPOSED WALLS, CEILING, FLOORS, ETC.
5. BIDDER'S ARE CAUTIONED TO NOTE SPECIFICATION ITEM REQUIRING EXAMINATION OF THE SITE.
6. BIDDER'S SHALL VERIFY LOCAL CODE REQUIREMENTS PRIOR TO BID SUBMITTAL AND SHALL INCLUDE ALL COSTS FOR COMPLETE COMPLIANCE WITH SAME.


# SYMBOLS

NOTE: ALL SYMBOLS INDICATED BELOW ARE NOT NECESSARILY UTILIZED ON THE FLOOR PLANS. FIXTURE TYPE - SEE LIGHTING FIXTURE SCHEDULE

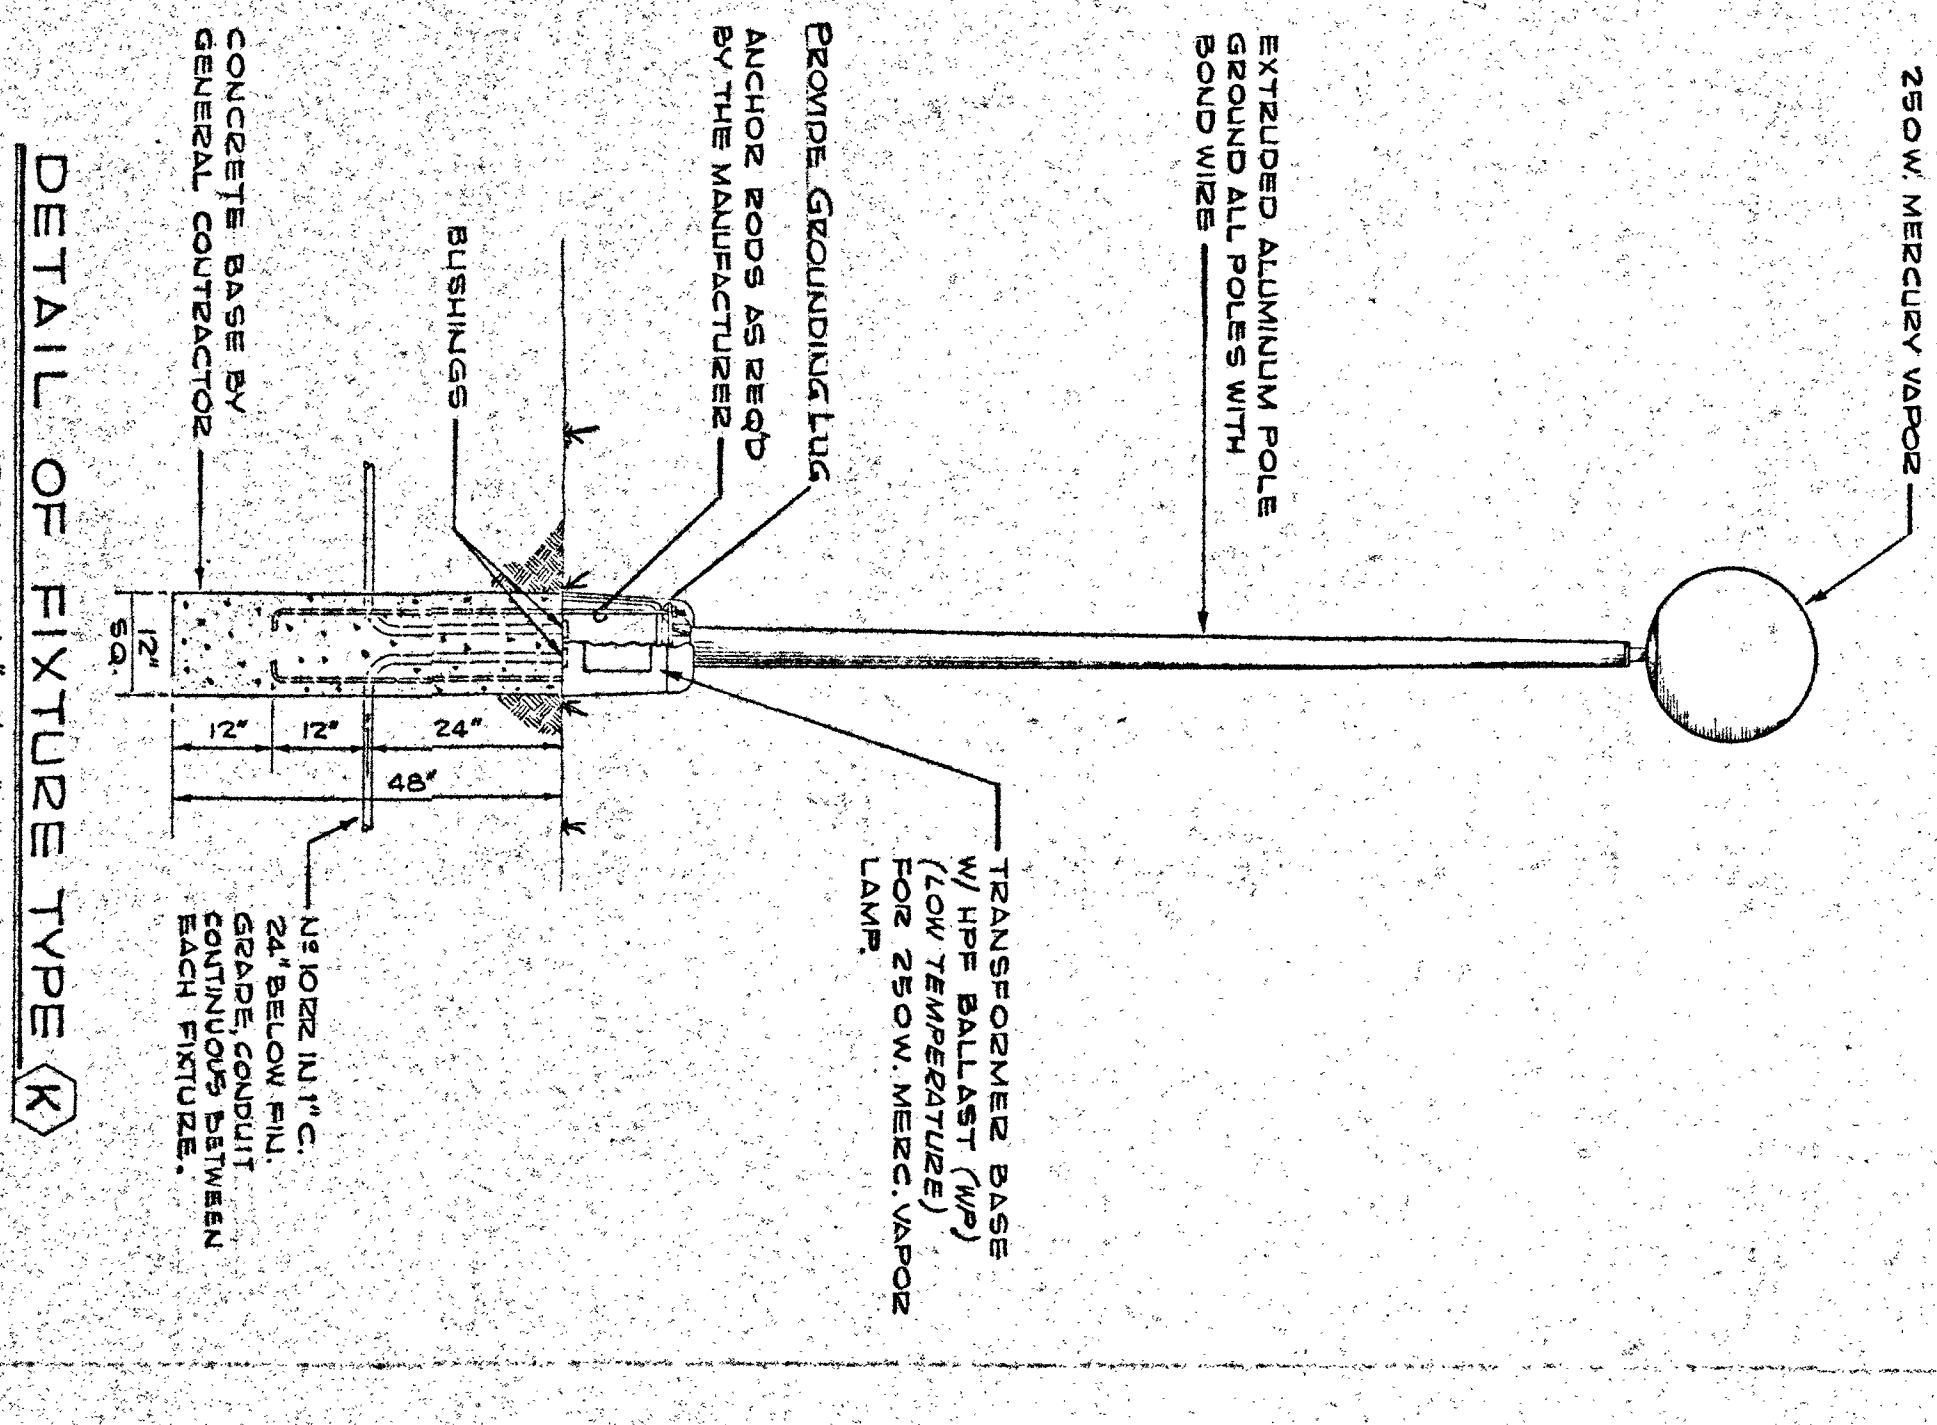

DETAIL OF FIXTURE TYPE (K)  
SCALE: 1/2" = 1'-0"


- 1. DISCONNECT SWITCH
- 2. MOTOR CONTROLLER - 2 DEVICES W/ PILOT LIGHT
- 3. PUSH BUTTON STATION (W/PILOT LIGHT)
- 4. PUSH BUTTON STATION (NON-INTERLOCK)
- 5. BUZZER W/ LOW VOLTAGE TRANSFORMER
- 6. FLUSH FLOOR BOX W/ MICROPHONE OUTLET - 2 DEVICES CLG AND WALL MTD MICROPHONE OUTLET
- 7. CALL-BACK SWITCH
- 8. CEILING MTD SPEAKER
- 9. WALL MTD SPEAKER
- 10. HORN TYPE SPEAKER
- 11. CLOCK HANGER OUTLET - CLOCKS N.I.C.
- 12. BELL ON PROGRAM SYSTEM
- 13. SPRINKLER SYSTEM FLOW ALARM CONNECTION
- 14. FIRE ALARM STRIKING STATION (UP 54")
- 15. FIRE ALARM SIGNAL (UP 96")
- 16. CEILING MTD HEAT DETECTOR
- 17. CEILING MTD SMOKE DETECTOR
- 18. SECURITY SYSTEM DETECTOR
- 19. ELECTRIC DOOR CLOSER CONNECTION
- 20. WIRELESS LOOP OUTLET (W/ 1/2" JACK & MATCHING CAP)
- 21. PULL BOX
- 22. DRY TYPE TRANSFORMER - SIZE AS INDICATED
- 23. PANELBOARD - 120/208VOLT
- 24. CONDUIT & WIRE RUN CONCEALED IN CEILING OR WALL
- 25. CONDUIT & WIRE RUN IN 02 UNDER FLOOR SLAB
- 26. HORIZONTAL TO PANELBOARD - ARROWS INDICATE THE NUMBER OF CIRCUITS LINES INDICATE THE NUMBER OF WIRES. NO LINES DEVOTES TWO WIRE CIRCUIT.
- 27. TELEPHONE CONDUIT & PULL-UP WIRE (NUL. 1/2") TO TEL. EQUIP. SPACE
- 28. WIREWOUND IN 3000 W/ DUPLEX RECEPTS ON 24" & 36" 1/2" D.U.M.
- 29. WEATHERPROOF
- 30. UN. UNLESS OTHERWISE NOTED.
- 31. NFSS NON-FUSED SAFETY SWITCH.
- 32. FSS FUSED SAFETY SWITCH.
- 33. EWC ELECTRIC WATER COOLER.
- 34. TELEVISION OUTLET - 1/8" 1/2" 1/4"
- 35. XFMG TRANSFORMER.

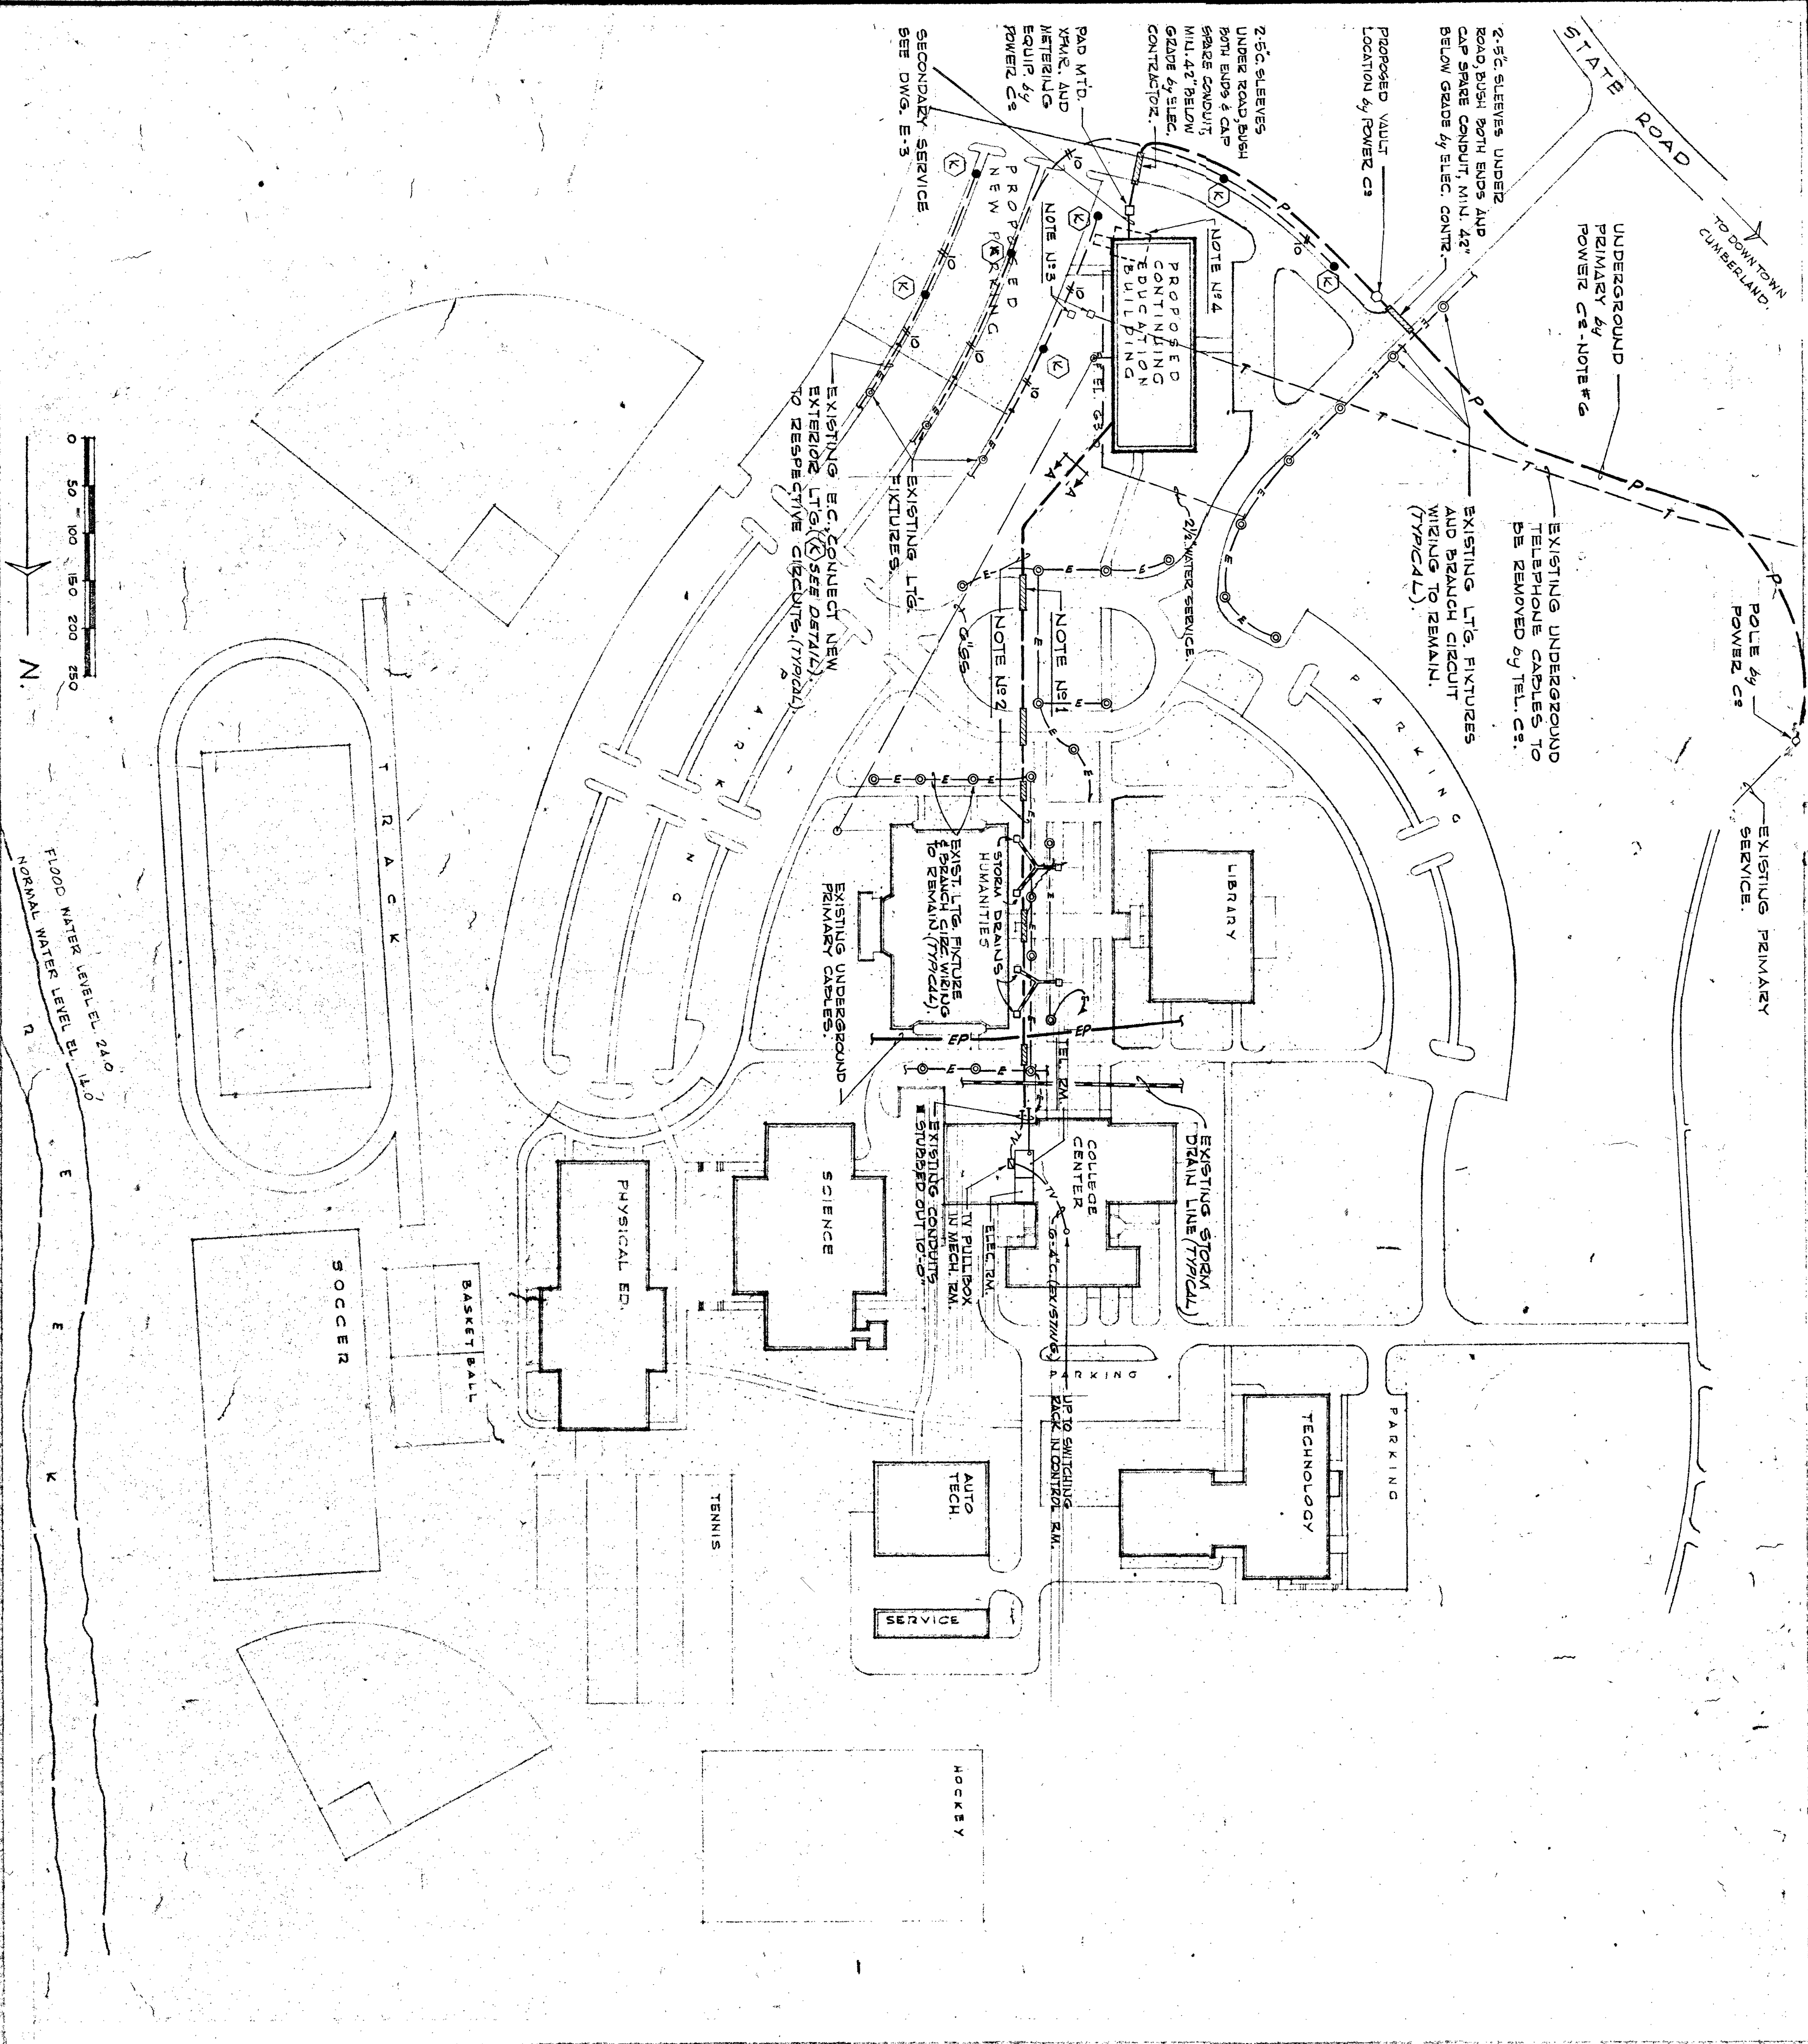

SITE PLAN  
SCALE: 1" = 100'-0"

# NOTES

1. PROVIDE 3.5" DIA. 20' BURIED LAMPING UNDER POWER AREAS AND CONCRETE SIDEWALKS.
2. DIRECT BURIAL CABLE, TELEPHONE, DIRECT BURIAL FIRE ALARM, SEE SECTION "A-A".
3. EXISTING TELEPHONE, PEDESTALS TO BE REMOVED OR TELEPHONE C/N.
4. EXISTING STRUCTURE TO BE REMOVED.
5. CONTRACTOR SHALL REMOVE ALL REMAINING SPOILED AREAS, PLANTS, SHRUBS, ETC. TO THEIR ORIGINAL CONDITION UPON COMPLETION. INSTALLATION OF ALL NEW UNDERGROUND CONDUITS OR CABLES.
6. ALL TRENCHING AND BACKFILL ASSOCIATED WITH THE PRIMARY REPAIR TO BE PERFORMED BY THE POWER CO. ALL OTHER BY THE CONTRACTOR.

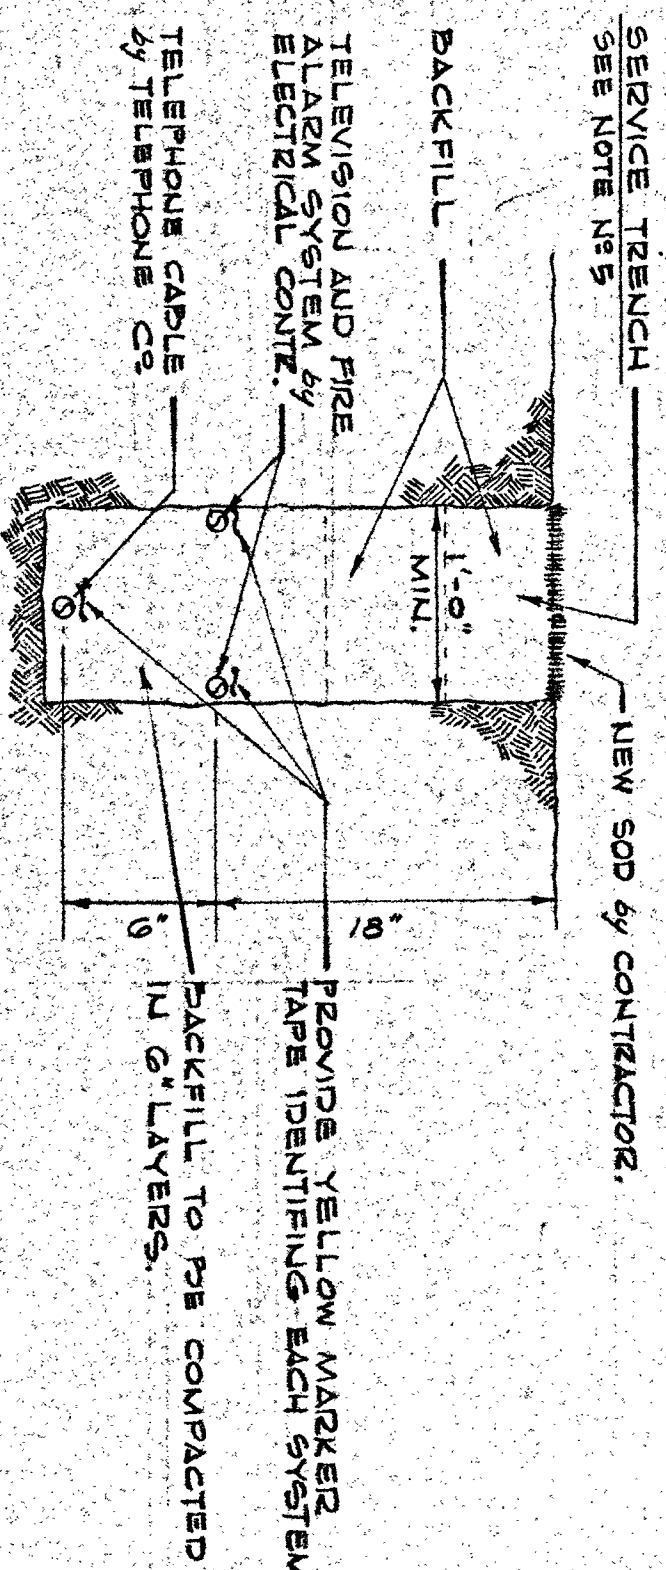

SECTION "A-A"  
NO SCALE

<b>DONAHUE &amp; MURRAY &amp; ASSOCIATES, INC.</b> 11111 RIVERSIDE DRIVE, SUITE 100 PITTSBURGH, PA 15203 (412) 261-1111 LICENSE NO. 11111		<b>CONTINUING EDUCATION BUILDING</b> ALLEGHENY COMMUNITY COLLEGE CUMBERLAND, MARYLAND	
DATE	3-1-77	BY	E-1
APP'D		CHK'D	E-4