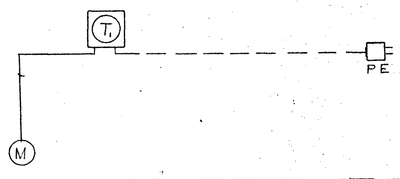

UNIT HEATER

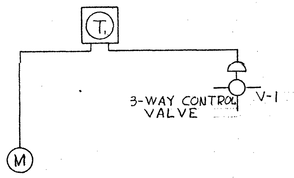

FAN COIL UNITS

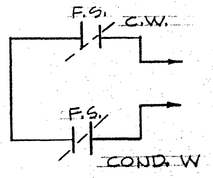

CHILLER INTERLOCK

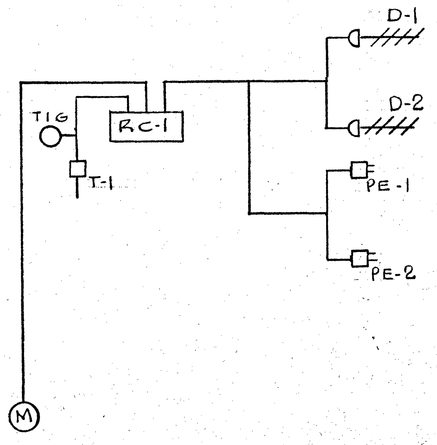

COOLING TOWER

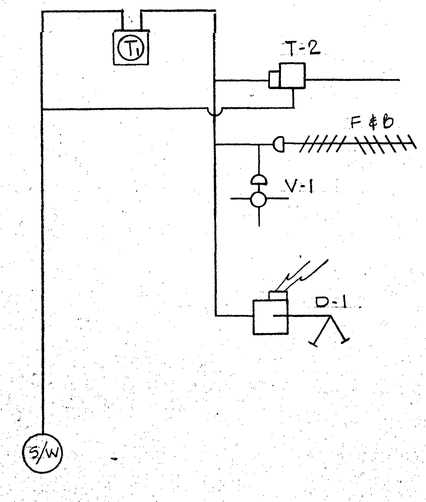

UNIT VENTILATORS

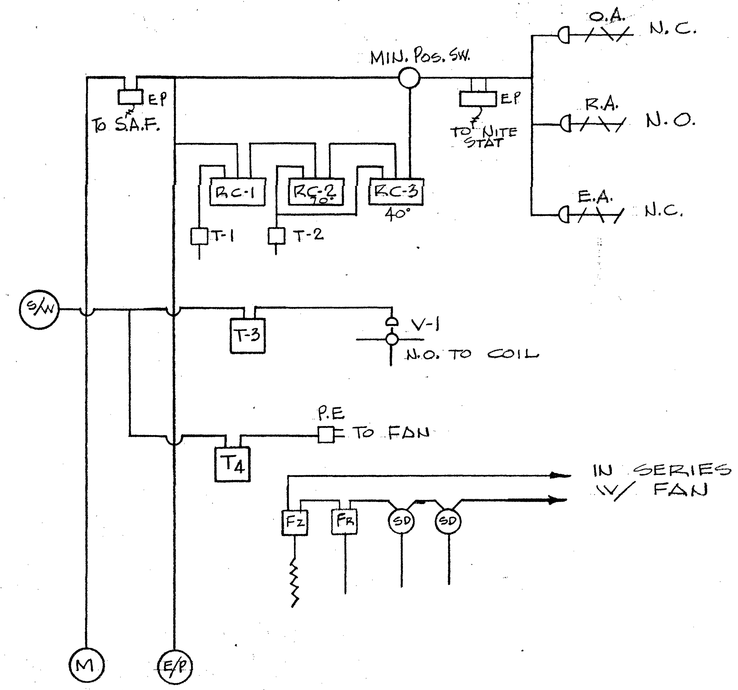

SINGLE ZONE A.H.U.

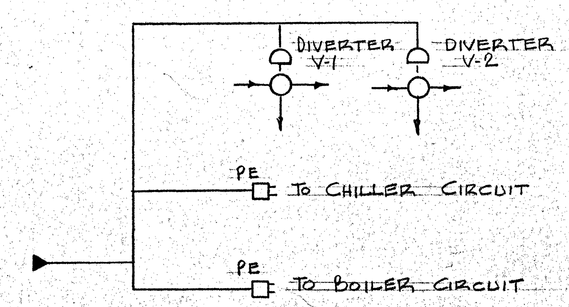

SUMMER-WINTER CHANGE-OVER SYSTEMS

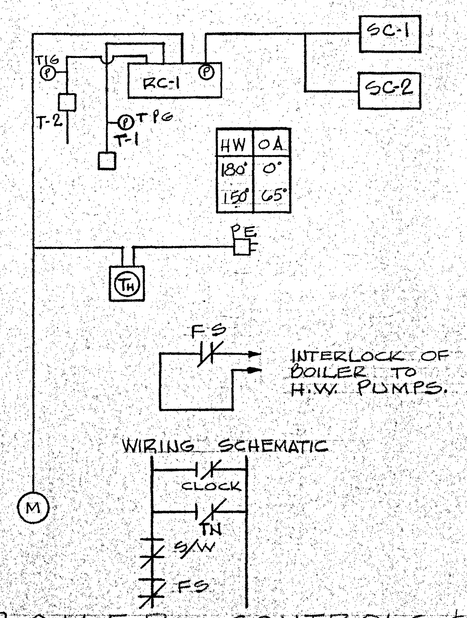

BOILER CONTROLS & RESET

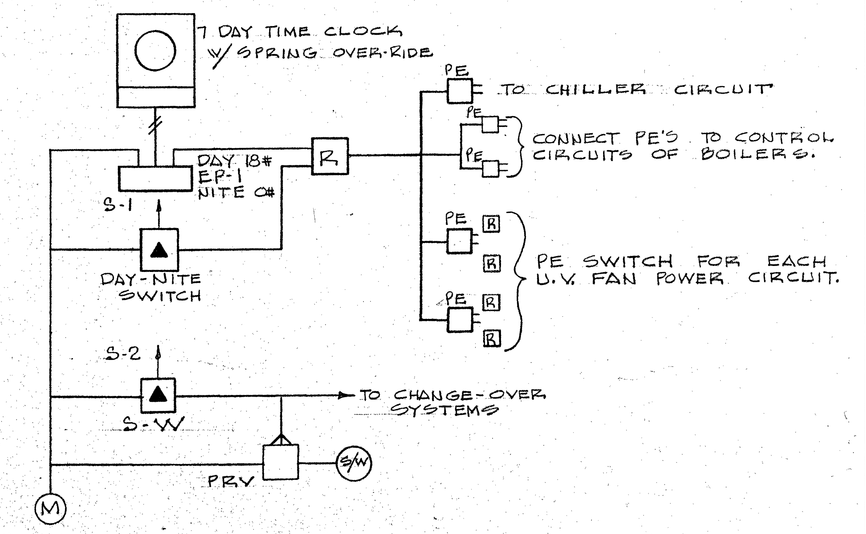

CONTROL PANEL

AUTOMATIC TEMPERATURE CONTROL DIAGRAMS

STATE OF MARYLAND — CHARLES R. MURRAY — No. 1755 — REGISTERED PROFESSIONAL ENGINEER

BOARD OF EXAMINERS AND REGISTRATION OF ARCHITECTS — 538A — STATE OF MARYLAND

PROJ ARCH

DRAWN

JOHANNES & MURRAY & ASSOCIATES
REGISTERED ARCHITECTS
SILVER SPRING, MARYLAND
8615 PERSHING DRIVE JU 9-3792

JAMES B. SULLIVAN JR. STRUCTURAL ENGINEER
J.B.WYBLE & ASSOC. MECHANICAL ENGINEER
HARRY G. FULFORD ELECTRICAL ENGINEER

APPROVED

CONTINUING EDUCATION BUILDING.

ALLEGANY COMMUNITY COLLEGE
CUMBERLAND MARYLAND

JOB G35-A
SHEET M-3 OF M-3
DATE 3-1-77